

COMMUNICATION AUGINESS COMMUNICATION AUGIN VISUAL SECURITY

Corporate Headquarters: 625 Locust Street, Suite 300 Garden City, NY 11530 631 254 4500 - fax: 631 254 4499

> 66 HUDSON BOULEVARD NEW YORK, NY 10001 7TH & 8TH FLOOR IDFS

PFIZER

ISSUE / REVISION LOG
No. Description Date
01 SUBMITTAL BULLETIN 4 01/14/22

01 SUBMITTAL BULLETIN 4 01/14/22
02 SUBMITTAL UPDATES 05/06/22
03 CISCO CODEC SIGNAL FLOW 09/23/22
04 AS BUILTS 06/22/23
05 ---- XX/XX/XX
06 ---- XX/XX/XX
07 ---- XX/XX/XX


[SUBMITTAL]


AUDIOVISUAL SYSTEM FLOWS & PULL SCHEDULE (CAFE CONNECT 08E030)

SHEET TITLE:

AV.S02.225

PROJ #: ANY-21131

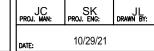

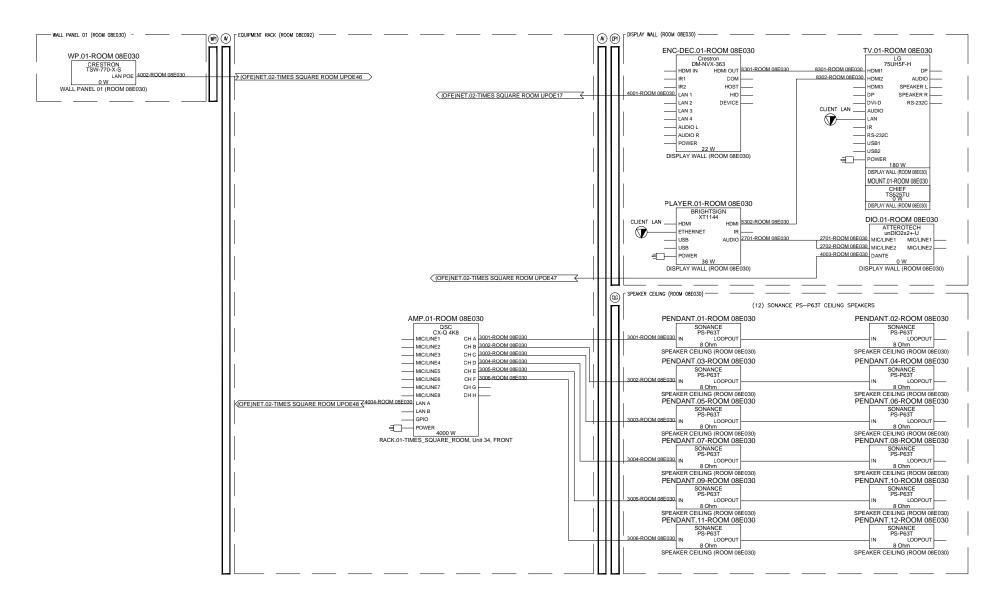

TYPE 46 CAFE CONNECT 08E030

SCALE: NTS

CableNumber	SysnameOut	ConnectorOut	PortOut	LocationOut	ModelOut	SysnameIn	ConnectorIn	PortIn	LocationIn	Modelin	CableType
4002-ROOM 08E030	WP.01-ROOM 08E030	RJ45	LAN POE	WALL PANEL 01 (ROOM 08E030)	Crestron TSW-770-X-S	(OFE)NET.02-TIMES SQUARE ROOM	RJ45	UPOE46	RACK.04-TIMES_SQUARE_ROOM, Unit 43, FRONT	Cisco C9300-48UXM-A	BELDEN 2413F
4001-ROOM 08E030	ENC-DEC.01-ROOM 08E030	RJ45	LAN 1	DISPLAY WALL (ROOM 08E030)	Crestron DM-NVX-363	(OFE)NET.02-TIMES SQUARE ROOM	RJ45	UPOE17	RACK.04-TIMES_SQUARE_ROOM, Unit 43, FRONT	Cisco C9300-48UXM-A	BELDEN 2413F
4003-ROOM 08E030	DIO.01-ROOM 08E030	RJ45	DANTE	DISPLAY WALL (ROOM 08E030)	ATTEROTECH unDIO2x2+-U	(OFE)NET.02-TIMES SQUARE ROOM	RJ45	UPOE47	RACK.04-TIMES_SQUARE_ROOM, Unit 43, FRONT	Cisco C9300-48UXM-A	BELDEN 2413F
3001-ROOM 08E030	PENDANT.01-ROOM 08E030	PHX	IN	SPEAKER CEILING (ROOM 08E030)	SONANCE PS-P63T	AMP.01-ROOM 08E030	EURO	CH A	RACK.01-TIMES_SQUARE_ROOM, Unit 34, FRONT	QSC CX-Q 4K8	BELDEN 6100UE
3002-ROOM 08E030	PENDANT.03-ROOM 08E030	PHX	IN	SPEAKER CEILING (ROOM 08E030)	SONANCE PS-P63T	AMP.01-ROOM 08E030	EURO	СН В	RACK.01-TIMES_SQUARE_ROOM, Unit 34, FRONT	QSC CX-Q 4K8	BELDEN 6100UE
3003-ROOM 08E030	PENDANT.05-ROOM 08E030	PHX	IN	SPEAKER CEILING (ROOM 08E030)	SONANCE PS-P63T	AMP.01-ROOM 08E030	EURO	сн с	RACK.01-TIMES_SQUARE_ROOM, Unit 34, FRONT	QSC CX-Q 4K8	BELDEN 6100UE
3004-ROOM 08E030	PENDANT.07-ROOM 08E030	PHX	IN	SPEAKER CEILING (ROOM 08E030)	SONANCE PS-P63T	AMP.01-ROOM 08E030	EURO	CH D	RACK.01-TIMES_SQUARE_ROOM, Unit 34, FRONT	QSC CX-Q 4K8	BELDEN 6100UE
3005-ROOM 08E030	PENDANT.09-ROOM 08E030	PHX	IN	SPEAKER CEILING (ROOM 08E030)	SONANCE PS-P63T	AMP.01-ROOM 08E030	EURO	CH E	RACK.01-TIMES_SQUARE_ROOM, Unit 34, FRONT	QSC CX-Q 4K8	BELDEN 6100UE
3006-ROOM 08E030	PENDANT.11-ROOM 08E030	PHX	IN	SPEAKER CEILING (ROOM 08E030)	SONANCE PS-P63T	AMP.01-ROOM 08E030	EURO	CH F	RACK.01-TIMES_SQUARE_ROOM, Unit 34, FRONT	QSC CX-Q 4K8	BELDEN 6100UE