


EQUIPMENT RACK (ROOM 07B041)

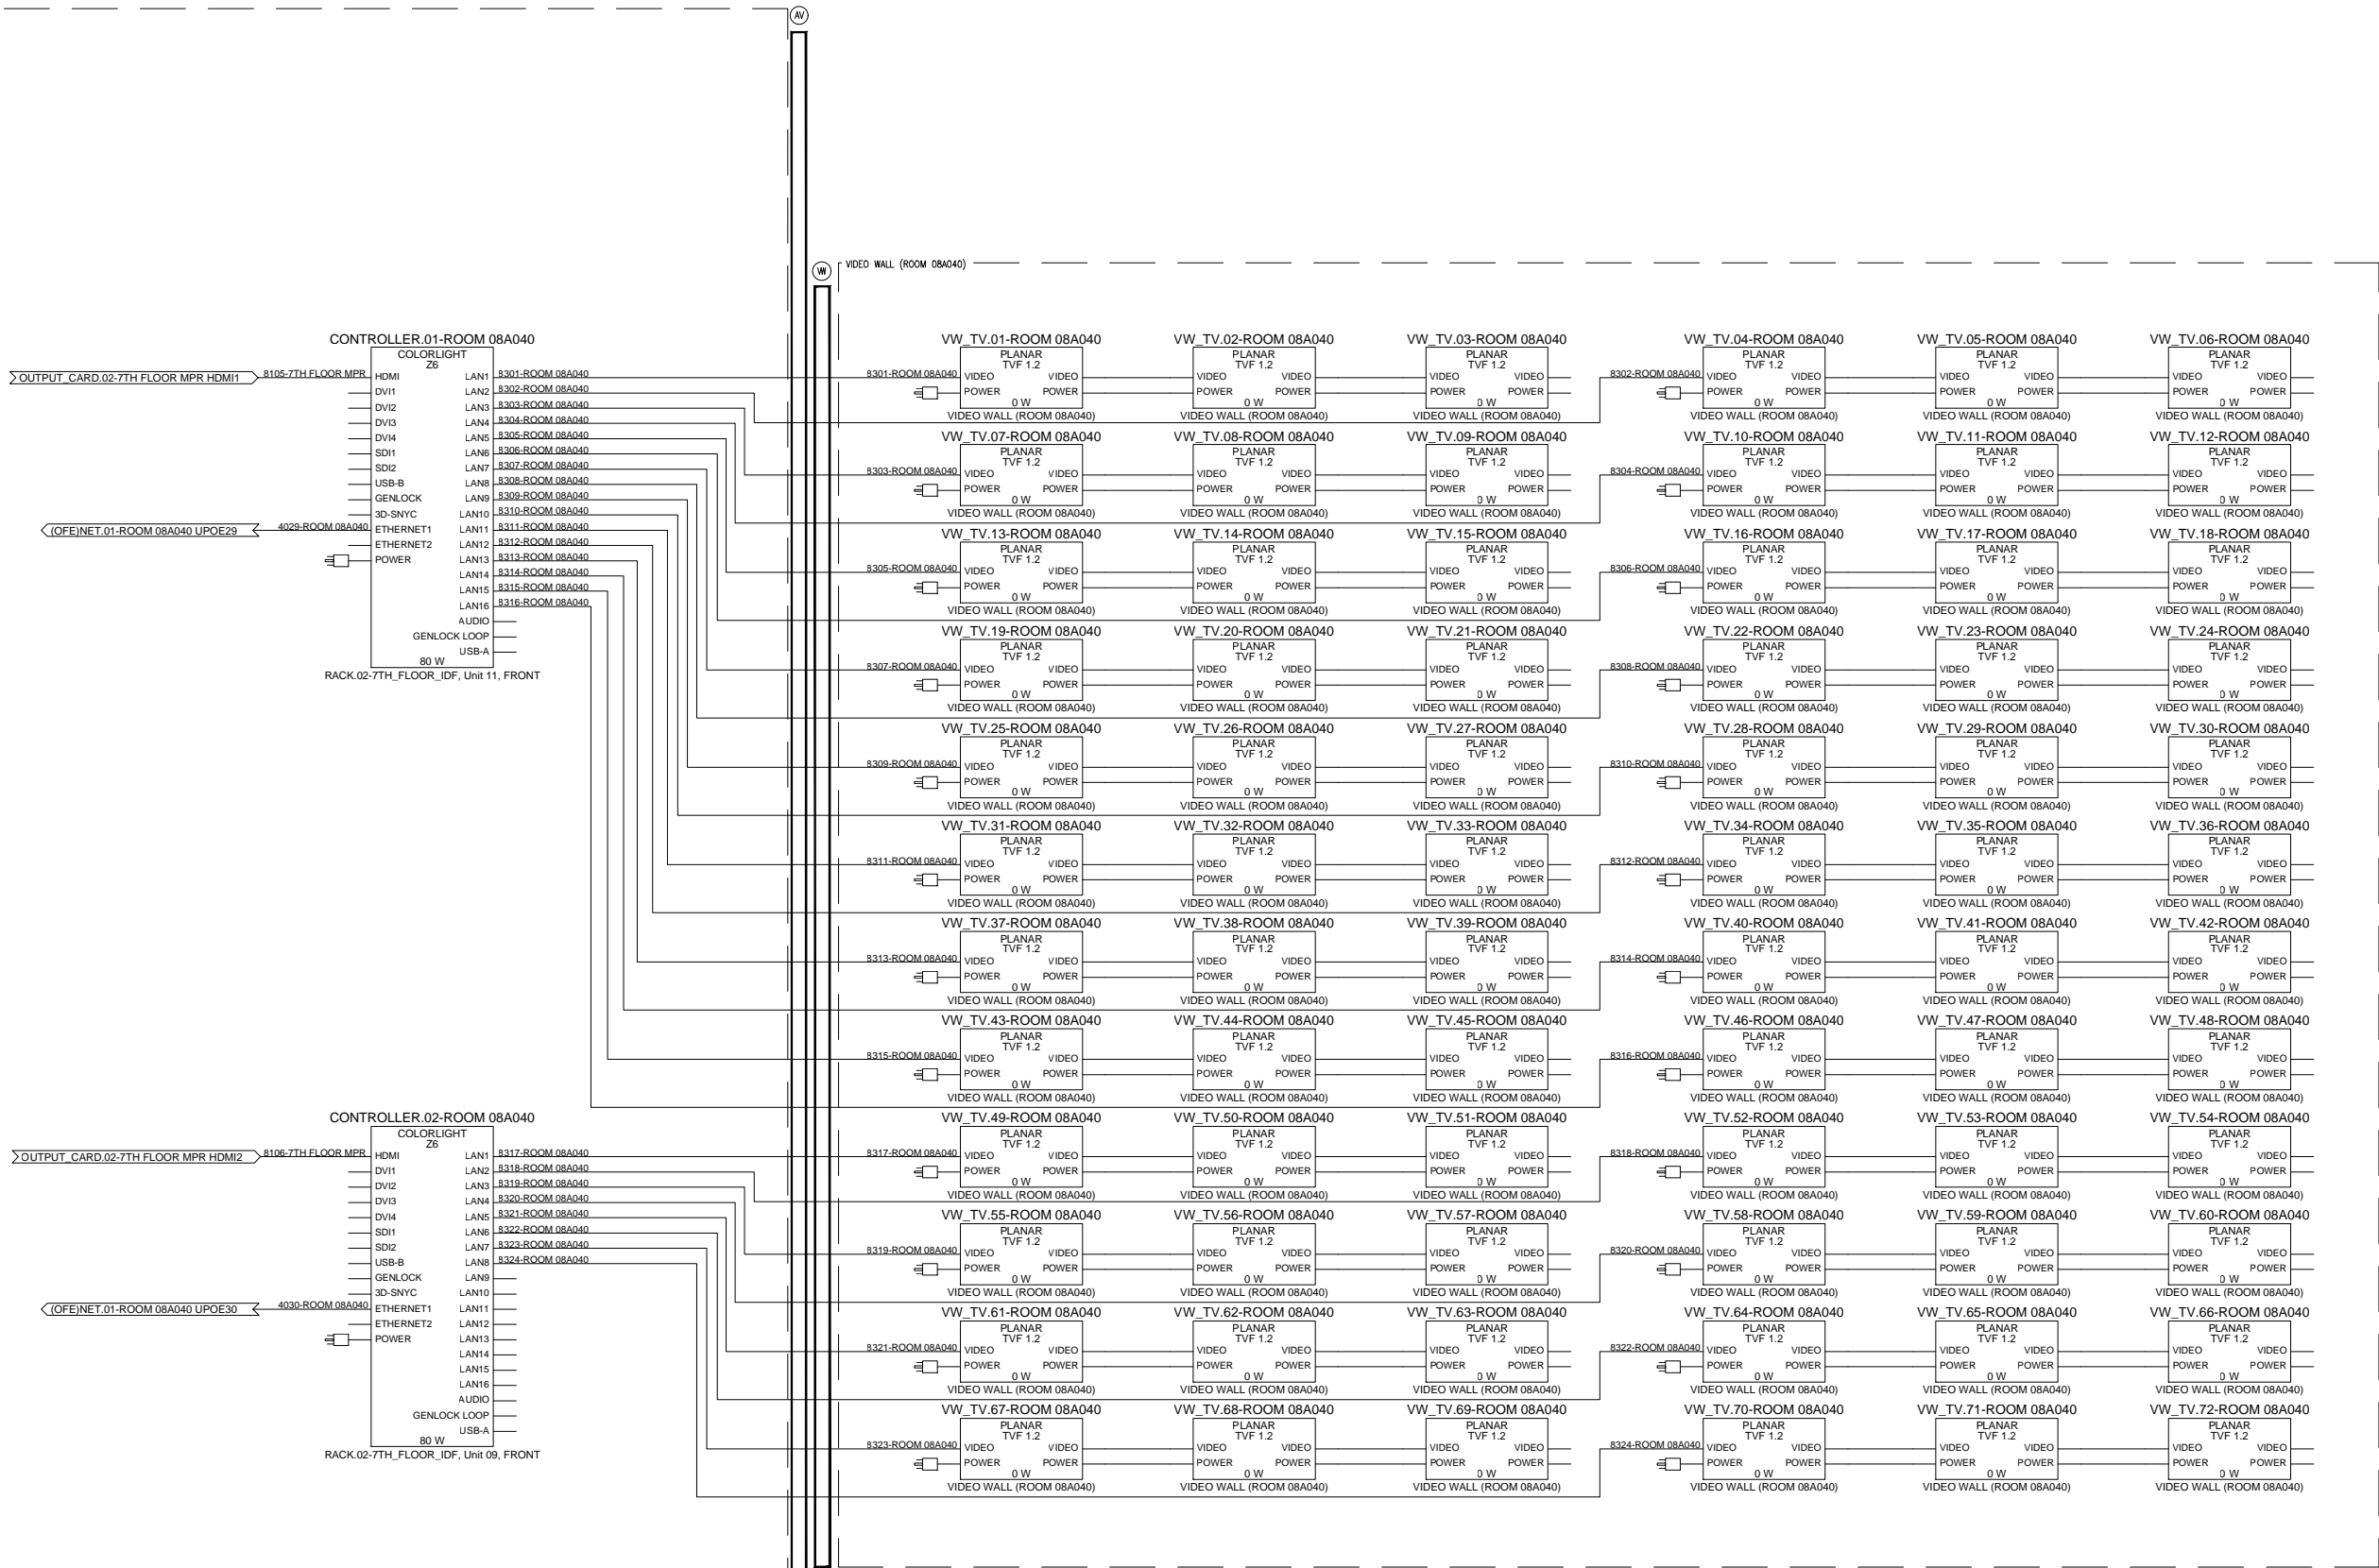

**TRITECH**  
CONNECTING YOUR BUSINESS  
communication audio visual security  
Corporate Headquarters:  
625 Locust Street, Suite 300  
Garden City, NY 11530  
631 254 4500 - fax: 631 254 4499

**Pfizer**  
66 HUDSON BOULEVARD  
NEW YORK, NY 10001  
7TH & 8TH FLOOR IDFS

ISSUE / REVISION LOG		
No.	Description	Date
01	SUBMITTAL BULLETIN 4	01/14/22
02	SUBMITTAL UPDATES	05/06/22
03	CISCO CODEC SIGNAL FLOW	09/23/22
04	AS BUILTS	06/22/23
05	----	XX/XX/XX
06	----	XX/XX/XX
07	----	XX/XX/XX

[SUBMITTAL]  
AUDIOVISUAL VIDEO  
SYSTEM FLOWS 02  
(GRANDSTAND  
08A040)

SHEET TITLE:

AV.S02.218  
DWG #:

PROJ #: ANY-21131

JC PROJ. MAN:	SK PROJ. ENG:	JL DRAWN BY:
------------------	------------------	-----------------

DATE: 10/29/21