Tad.

TRITECH
CONNECTING YOUR BUSINESS
communication audio visual
security

Corporate Headquarters: 625 Locust Street, Suite 300 Garden City, NY 11530 631 254 4500 - fax: 631 254 4499

> 66 HUDSON BOULEVARD NEW YORK, NY 10001 7TH & 8TH FLOOR IDFS

**PFIZER** 

ISSUE / REVISION LOG

No. Description Date

1 SUBMITTAL BULLETIN 4 01/14/22

2 SUBMITTAL UPDATES 05/06/22

02 SUBMITTAL UPDATES 05/06/22
03 CISCO CODEC SIGNAL FLOW 09/23/22
04 AS BUILTS 06/22/23
05 ---- XX/XX/XX
06 ---- XX/XX/XX
07 ---- XX/XX/XX


[SUBMITTAL]


AUDIOVISUAL SYSTEM FLOWS & PULL SCHEDULE (BUSINESS LOUNGE 08E020)

SHEET TITLE:

AV.S02.224

PROJ #: ANY-21131

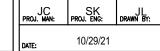

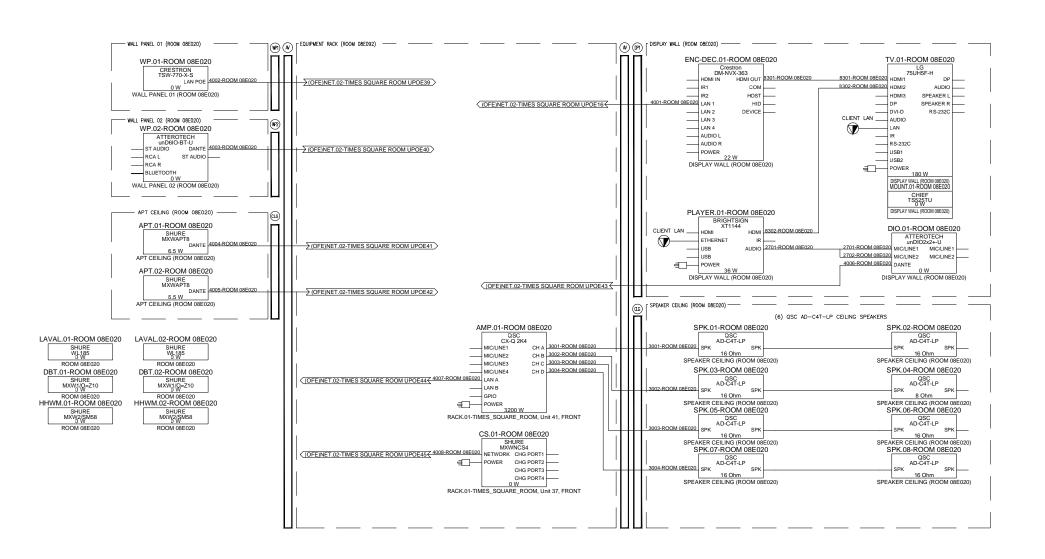



CableNumber	SysnameOut	ConnectorOut	PortOut	LocationOut	ModelOut	Sysnamein	Connectorin	Portin	LocationIn	Modelin	CableType
4002-ROOM 08E020	WP.01-ROOM 08E020	RJ45	LAN POE	WALL PANEL 01 (ROOM 08E020)	Crestron TSW-770-X-S	(OFE)NET.02-TIMES SQUARE ROOM	RJ45	UPOE39	RACK.04-TIMES_SQUARE_ROOM, Unit 43, FRONT	Cisco C9300-48UXM-A	BELDEN 2413F
4003-ROOM 08E020	WP.02-ROOM 08E020	RJ45	DANTE	WALL PANEL 02 (ROOM 08E020)	ATTEROTECH unD6IO-BT-U	(OFE)NET.02-TIMES SQUARE ROOM	RJ45	UPOE40	RACK.04-TIMES_SQUARE_ROOM, Unit 43, FRONT	Cisco C9300-48UXM-A	BELDEN 2413F
4004-ROOM 08E020	APT.01-ROOM 08E020	RJ45	DANTE	APT CEILING (ROOM 08E020)	SHURE MXWAPT8	(OFE)NET.02-TIMES SQUARE ROOM	RJ45	UPOE41	RACK.04-TIMES_SQUARE_ROOM, Unit 43, FRONT	Cisco C9300-48UXM-A	BELDEN 2413F
4005-ROOM 08E020	APT.02-ROOM 08E020	RJ45	DANTE	APT CEILING (ROOM 08E020)	SHURE MXWAPT8	(OFE)NET.02-TIMES SQUARE ROOM	RJ45	UPOE42	RACK.04-TIMES_SQUARE_ROOM, Unit 43, FRONT	Cisco C9300-48UXM-A	BELDEN 2413F
4001-ROOM 08E020	ENC-DEC.01-ROOM 08E020	RJ45	LAN 1	DISPLAY WALL (ROOM 08E020)	Crestron DM-NVX-363	(OFE)NET.02-TIMES SQUARE ROOM	RJ45	UPOE16	RACK.04-TIMES_SQUARE_ROOM, Unit 43, FRONT	Cisco C9300-48UXM-A	BELDEN 2413F
4006-ROOM 08E020	DIO.01-ROOM 08E020	RJ45	DANTE	DISPLAY WALL (ROOM 08E020)	ATTEROTECH unDIO2x2+-U	(OFE)NET.02-TIMES SQUARE ROOM	RJ45	UPOE43	RACK.04-TIMES_SQUARE_ROOM, Unit 43, FRONT	Cisco C9300-48UXM-A	BELDEN 2413F
3001-ROOM 08E020	SPK.01-ROOM 08E020	3PIN	SPK	SPEAKER CEILING (ROOM 08E020)	QSC AD-C4T-LP	AMP.01-ROOM 08E020	EURO	CH A	RACK.01-TIMES_SQUARE_ROOM, Unit 41, FRONT	QSC CX-Q 2K4	BELDEN 6100UE
3002-ROOM 08E020	SPK.03-ROOM 08E020	3PIN	SPK	SPEAKER CEILING (ROOM 08E020)	QSC AD-C4T-LP	AMP.01-ROOM 08E020	EURO	CH B	RACK.01-TIMES_SQUARE_ROOM, Unit 41, FRONT	QSC CX-Q 2K4	BELDEN 6100UE
3003-ROOM 08E020	SPK.05-ROOM 08E020	3PIN	SPK	SPEAKER CEILING (ROOM 08E020)	QSC AD-C4T-LP	AMP.01-ROOM 08E020	EURO	CH C	RACK.01-TIMES_SQUARE_ROOM, Unit 41, FRONT	QSC CX-Q 2K4	BELDEN 6100UE
3004-ROOM 08E020	SPK.07-ROOM 08E020	3PIN	SPK	SPEAKER CEILING (ROOM 08E020)	QSC AD-C4T-LP	AMP.01-ROOM 08E020	EURO	CH D	RACK.01-TIMES_SQUARE_ROOM, Unit 41, FRONT	QSC CX-Q 2K4	BELDEN 6100UE