

TRITECH
CONNECTING YOUR BUSINESS
COMMUNICATION audio visual
Security

Corporate Headquarters: 625 Locust Street, Suite 300 Garden City, NY 11530 631 254 4500 - fax: 631 254 4499

PFIZER
66 HUDSON BOULEVARD
NEW YORK, NY 10001
7TH & 8TH FLOOR IDFS

02 SUBMITTAL UPDATES 05/06/22
03 CISCO CODEC SIGNAL FLOW 09/23/22
04 AS BUILTS 06/22/23
05 ---- XX/XX/XX
06 ---- XX/XX/XX
07 ---- XX/XX/XX


[SUBMITTAL]


AUDIOVISUAL SYSTEM
FLOWS & PULL
SCHEDULE
(PREFUNCTION AREA
08C110)

SHEET TITLE:

AV.S02.221

PROJ #: ANY-21131

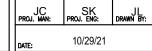

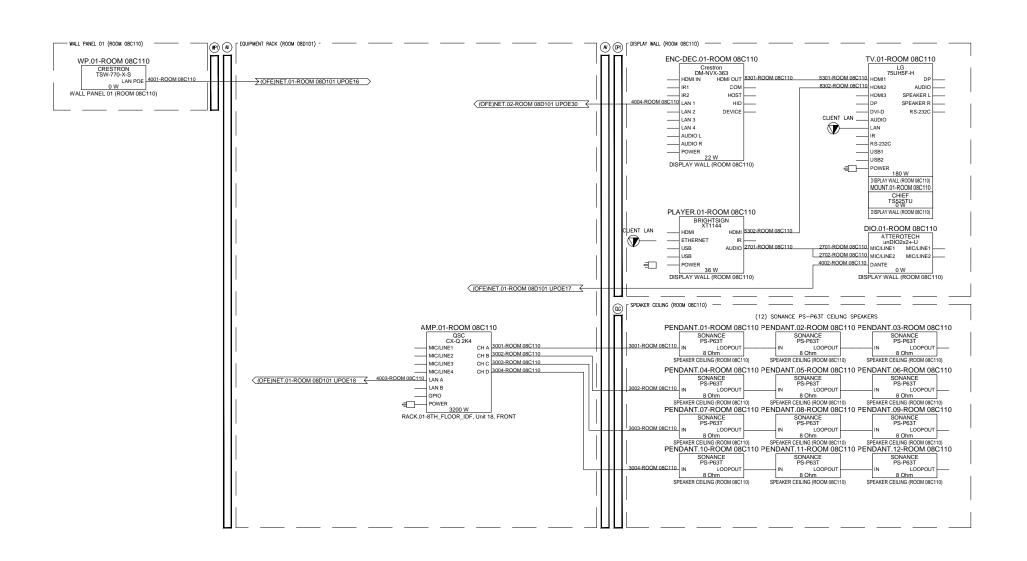



TYPE 47 PREFUNCTION AREA 08C110

SCALE: NTS

CableNumber	SysnameOut	ConnectorOut	PortOut	LocationOut	ModelOut	SysnameIn	ConnectorIn	PortIn	LocationIn	Modelln	CableType
4001-ROOM 08C110	WP.01-ROOM 08C110	RJ45	LAN POE	WALL PANEL 01 (ROOM 08C110)	Crestron TSW-770-X-S	(OFE)NET.01-ROOM 08D101	RJ45	UPOE16	RACK.01-8TH_FLOOR_IDF, Unit 05, FRONT	Cisco C9300-48UXM-A	BELDEN 2413F
4004-ROOM 08C110	ENC-DEC.01-ROOM 08C110	RJ45	LAN 1	DISPLAY WALL (ROOM 08C110)	Crestron DM-NVX-363	(OFE)NET.02-ROOM 08D101	RJ45	UPOE30	RACK.01-8TH_FLOOR_IDF, Unit 03, FRONT	Cisco C9300-48UXM-A	BELDEN 2413F
4002-ROOM 08C110	DIO.01-ROOM 08C110	RJ45	DANTE	DISPLAY WALL (ROOM 08C110)	ATTEROTECH unDIO2x2+-U	(OFE)NET.01-ROOM 08D101	RJ45	UPOE17	RACK.01-8TH_FLOOR_IDF, Unit 05, FRONT	Cisco C9300-48UXM-A	BELDEN 2413F
3001-ROOM 08C110	PENDANT.01-ROOM 08C110	PHX	IN	SPEAKER CEILING (ROOM 08C110)	SONANCE PS-P63T	AMP.01-ROOM 08C110	EURO	CH A	RACK.01-8TH_FLOOR_IDF, Unit 18, FRONT	QSC CX-Q 2K4	BELDEN 6100UE
3002-ROOM 08C110	PENDANT.04-ROOM 08C110	PHX	IN	SPEAKER CEILING (ROOM 08C110)	SONANCE PS-P63T	AMP.01-ROOM 08C110	EURO	CH B	RACK.01-8TH_FLOOR_IDF, Unit 18, FRONT	QSC CX-Q 2K4	BELDEN 6100UE
3003-ROOM 08C110	PENDANT.07-ROOM 08C110	PHX	IN	SPEAKER CEILING (ROOM 08C110)	SONANCE PS-P63T	AMP.01-ROOM 08C110	EURO	CH C	RACK.01-8TH_FLOOR_IDF, Unit 18, FRONT	QSC CX-Q 2K4	BELDEN 6100UE
3004-ROOM 08C110	PENDANT.10-ROOM 08C110	PHX	IN	SPEAKER CEILING (ROOM 08C110)	SONANCE PS-P63T	AMP.01-ROOM 08C110	EURO	CH D	RACK.01-8TH_FLOOR_IDF, Unit 18, FRONT	QSC CX-Q 2K4	BELDEN 6100UE