
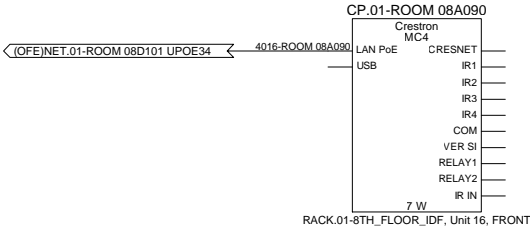


# Control Backbone:

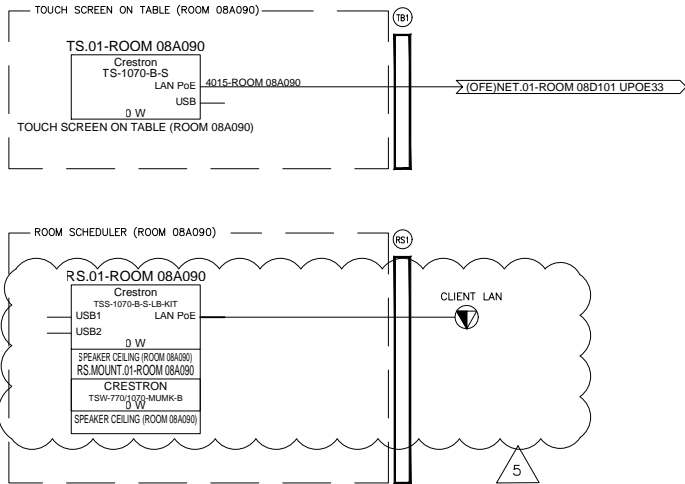

Tad.

**TRITECH**  
CONNECTING YOUR BUSINESS  
communication audio visual security

Corporate Headquarters:  
625 Locust Street, Suite 300  
Garden City, NY 11530  
631 254 4500 - fax: 631 254 4499

**PFIZER**

**66 HUDSON BOULEVARD**  
**NEW YORK, NY 10001**  
**7TH & 8TH FLOOR IDFS**

## ISSUE / REVISION LOG

No.	Description	Date
01	SUBMITTAL BULLETIN 4	01/14/22
02	SUBMITTAL UPDATES	05/06/22
03	CISCO CODEC SIGNAL FLOW	09/23/22
04	AS BUILTS	06/22/23
05	----	XX/XX/XX
06	----	XX/XX/XX
07	----	XX/XX/XX

[SUBMITTAL]  
AUDIOVISUAL  
CONTROL SYSTEM  
FLOWS  
(AMENITIES  
BOARDROOM  
08A090)

SHEET TITLE:

**AV.S02.404**

DWG #:

PROJ #: ANY-21131

JC PROJ. MAN:	SK PROJ. ENG:	JL DRAWN BY:
------------------	------------------	-----------------

DATE: 10/29/21