

30" x 42" - Arch E Size

2.0 2.3 3.0 4.0 5.0 6.0 7.0 8.0 9.0 10.0 11.0

SHEET NOTES:

1. ROUTE ALL DEVICES, UNLESS OTHERWISE NOTED, TO IDF/AV ROOM 08D101.



tmt technology partners, llc

- NO EXCEPTIONS TAKEN  
CORRECT AS NOTED  
REVISE & RESUBMIT  
REJECTED  
NOT REVIEWED

PFIZER NYHQ

66 HUDSON BOULEVARD, NEW YORK, NY 10001

ISSUE	DATE	BY	DESCRIPTION
1	08/27/2021	JH	ISSUED FOR CONSTRUCTION
2	09/01/2021	JH	REVISED PER SHOP DRAWING REVIEW
3	09/01/2021	JH	REVISED PER SHOP DRAWING REVIEW

DRAWN BY: J. Hauser  
CHECKED BY: J. Newby  
ISSUE DATE: 08/27/2021  
JOB NUMBER:  
PROJECT #:

SYSTEM:  
ACS, VSS, & ECS

SHEET:

8TH FLOOR DEVICE  
PLACEMENT PLAN

SE-106

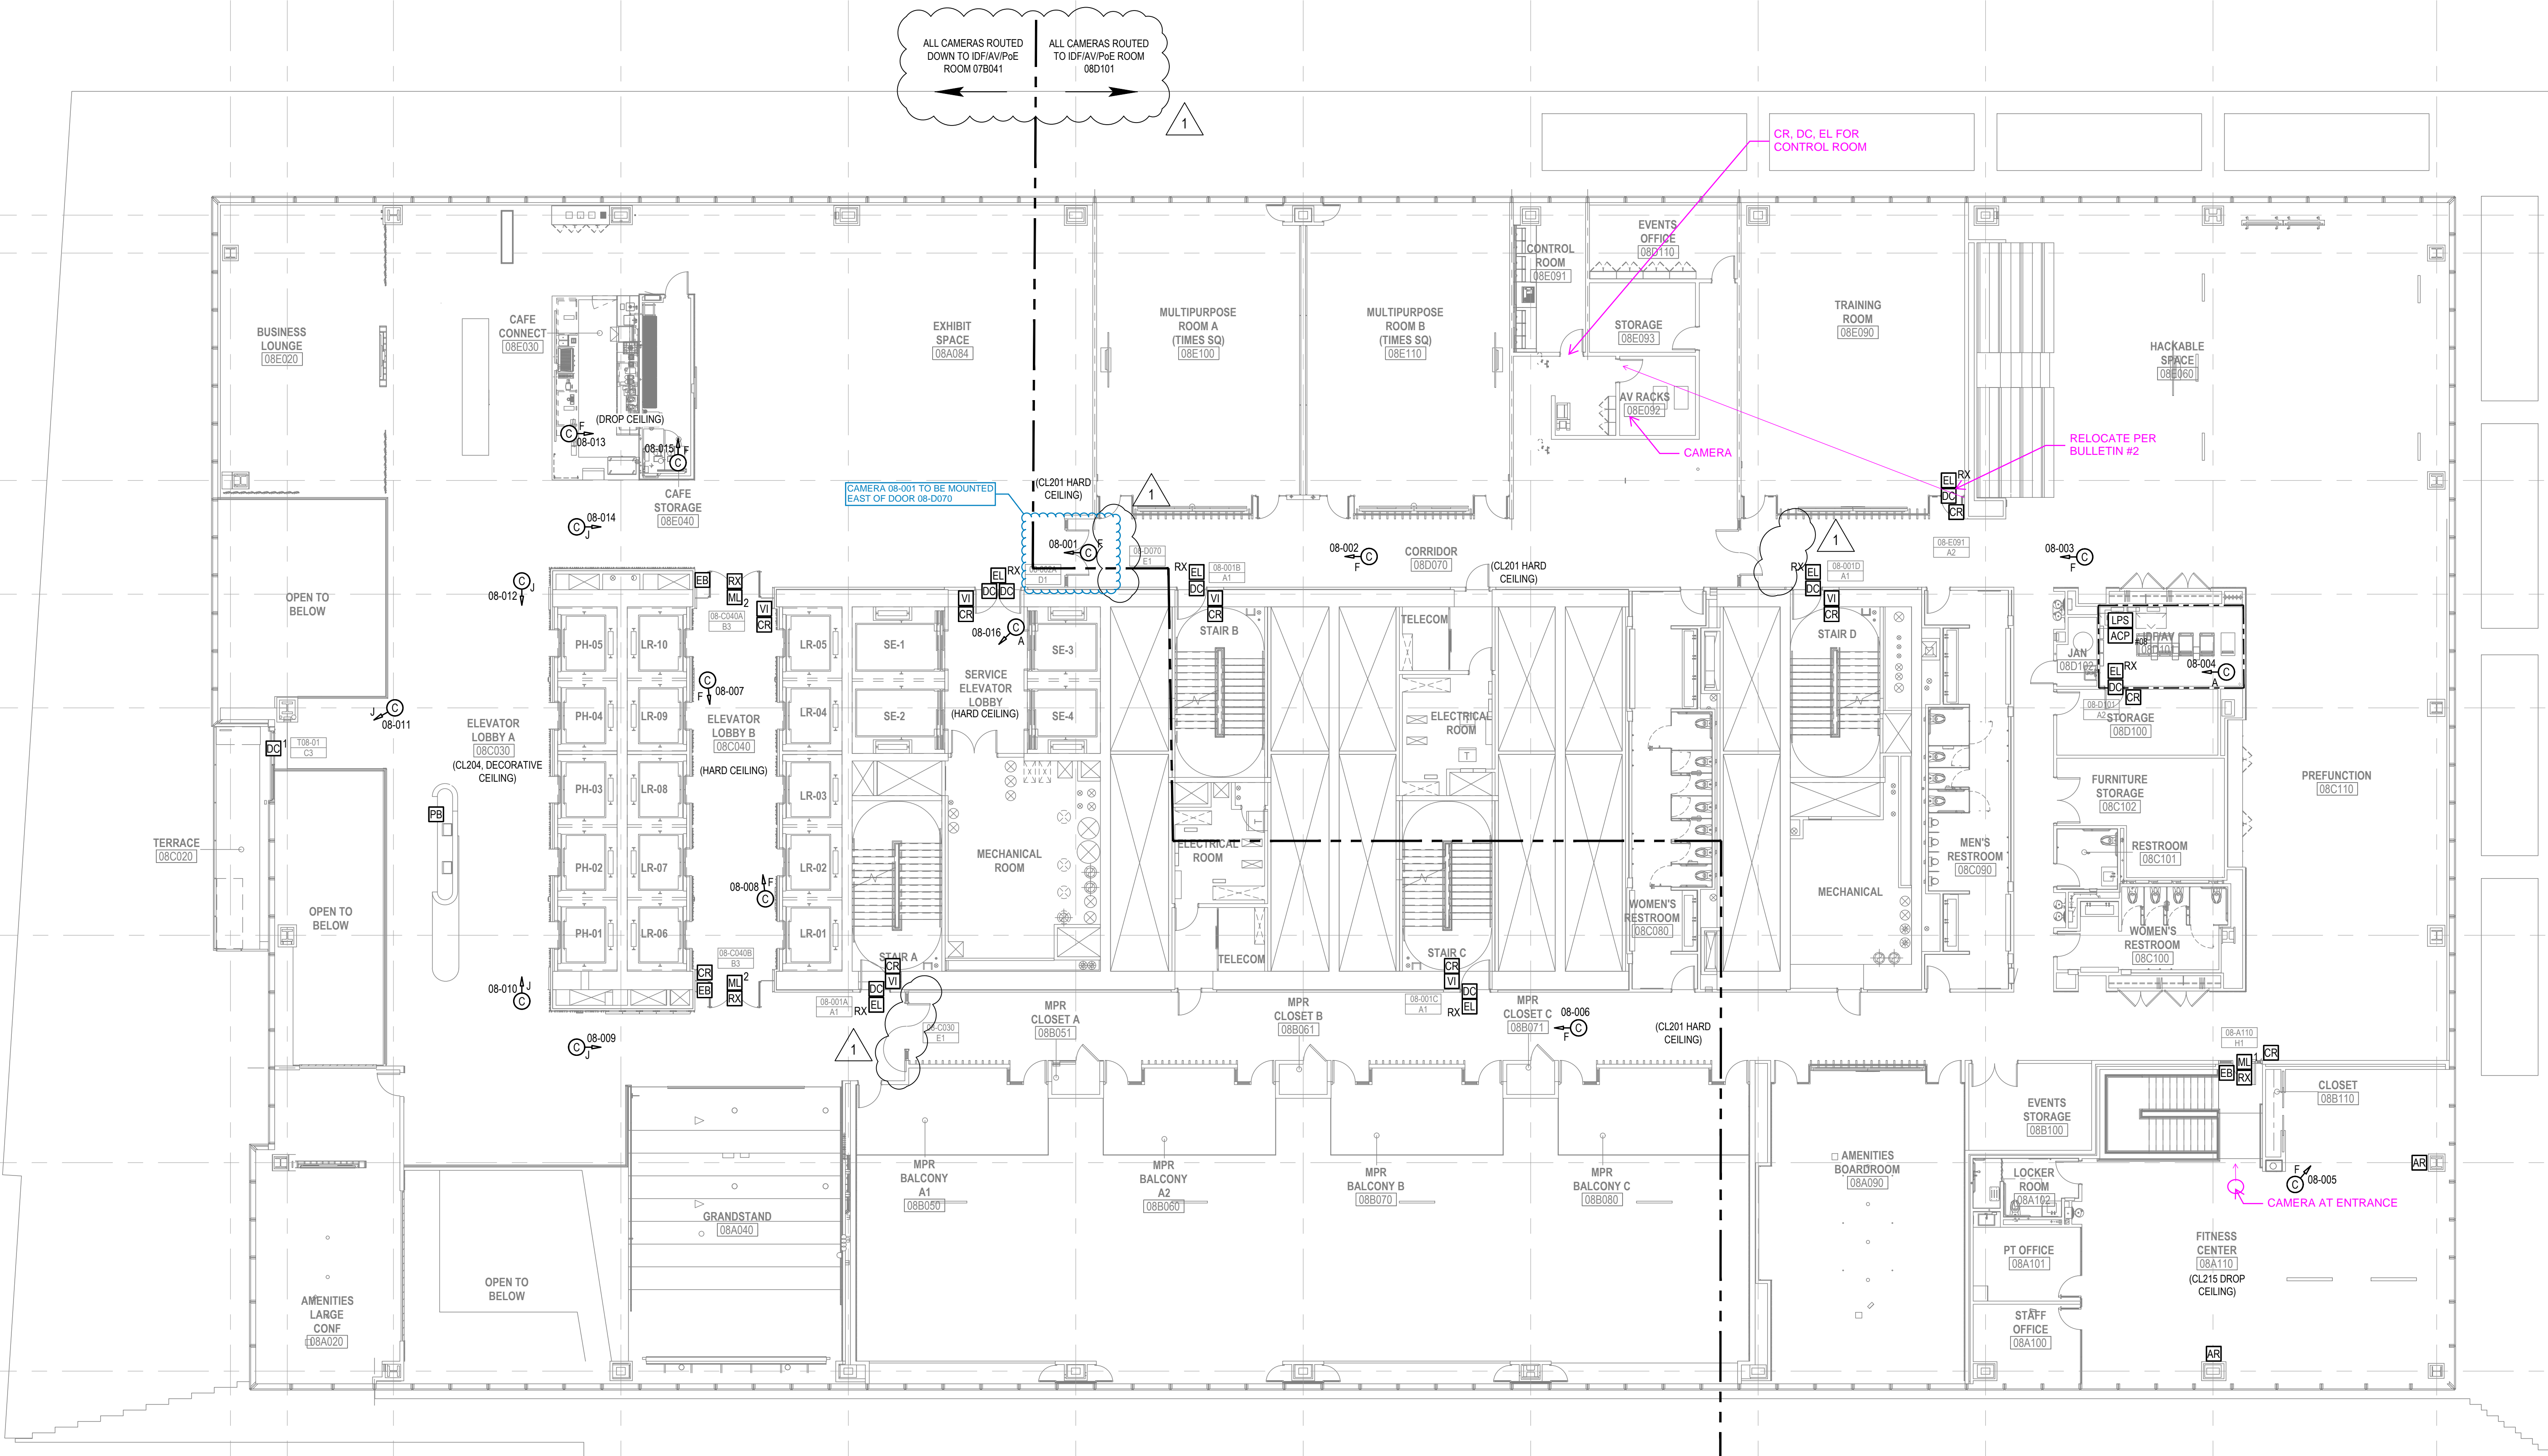

DEVICE PLACEMENT PLAN - 8th FLOOR PLAN

SCALE: 3/32" = 1'-0"

SCALE: 3/32" = 1'-0" IN FEET