



Corporate Headquarters: 625 Locust Street, Suite 300 Garden City, NY 11530 631 254 4500 - fax: 631 254 4499

PFIZER
66 HUDSON BOULEVARD
NEW YORK, NY 10001
7TH & 8TH FLOOR IDFS

## ISSUE / REVISION LOG

No.	Description	Date
01		01/14/22
02	SUBMITTAL UPDATES	05/06/22
03	CISCO CODEC SIGNAL FLOW	09/23/22
04	AS BUILTS	06/22/23
05		XX/XX/XX
06		XX/XX/XX
07		XX/XX/XX


[SUBMITTAL]


AUDIOVISUAL RACK & POWER DETAILS 01 (IDF 07B041)

SHEET TITLE:

AV.S02.101

PROJ #: ANY-21131

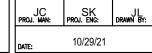

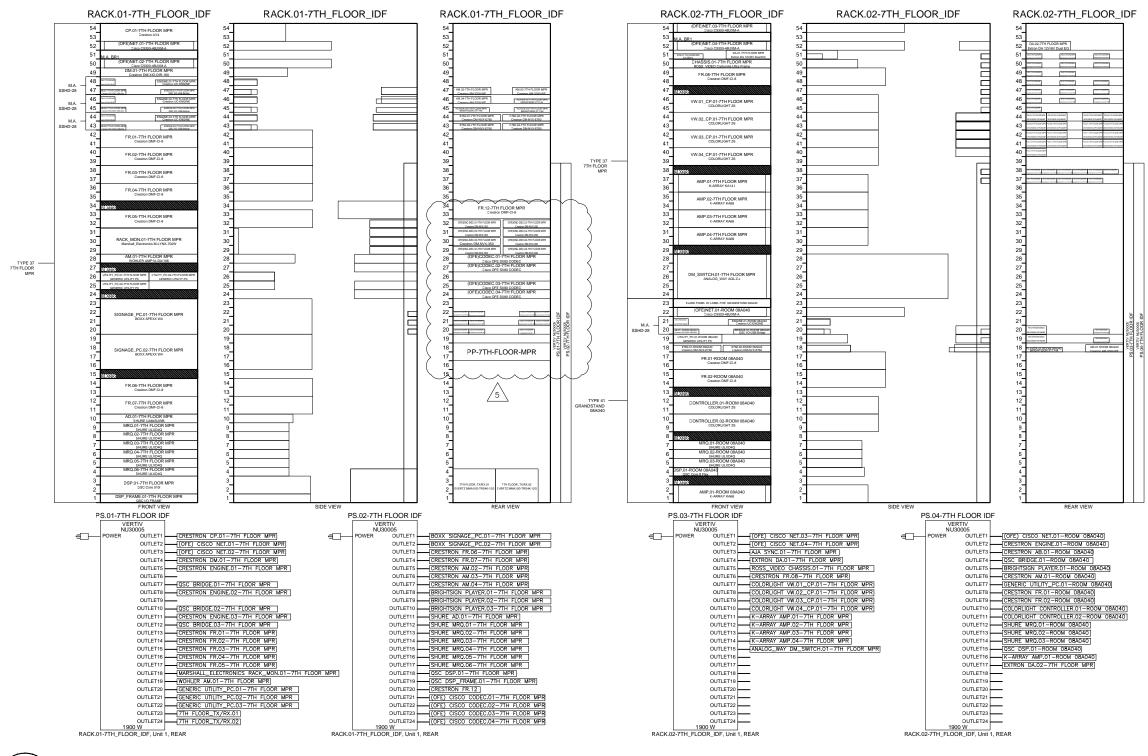

EQUIPMENT RACK-7TH FLOOR 07B041

- 3- MIDDLE ATLANTIC VMRK-54-36LRD
- 3 MIDDLE ATLANTIC SPN-44-36 (PAIR)
- 6 VERTIV NU30005