



Tad.

**TRITECH**
CONNECTING YOUR BUSINESS
communication audio visual security

Corporate Headquarters:
625 Locust Street, Suite 300
Garden City, NY 11530
631 254 4500 • fax: 631 254 4499

PFIZER

**66 HUDSON BOULEVARD
NEW YORK, NY 10001
7TH & 8TH FLOOR IDFS**

ISSUE / REVISION LOG		
No.	Description	Date
01	SUBMITTAL BULLETIN 4	01/14/22
02	SUBMITTAL UPDATES	05/06/22
03	CISCO CODEC SIGNAL FLOW	09/23/22
04	AS BUILTS	06/22/23
05	----	XX/XX/XX
06	----	XX/XX/XX
07	----	XX/XX/XX

[SUBMITTAL]
AUDIOVISUAL
SYSTEM FLOWS &
PULL SCHEDULE
(AMENITIES
ELEVATOR LOBBY B
07-010)

SHEET TITLE:


AV.S02.212

DWG #:

PROJ #: ANY-21131

JC PROJ. MAN:	SK PROJ. ENG:	JL DRAWN BY:
------------------	------------------	-----------------

DATE: 10/29/21

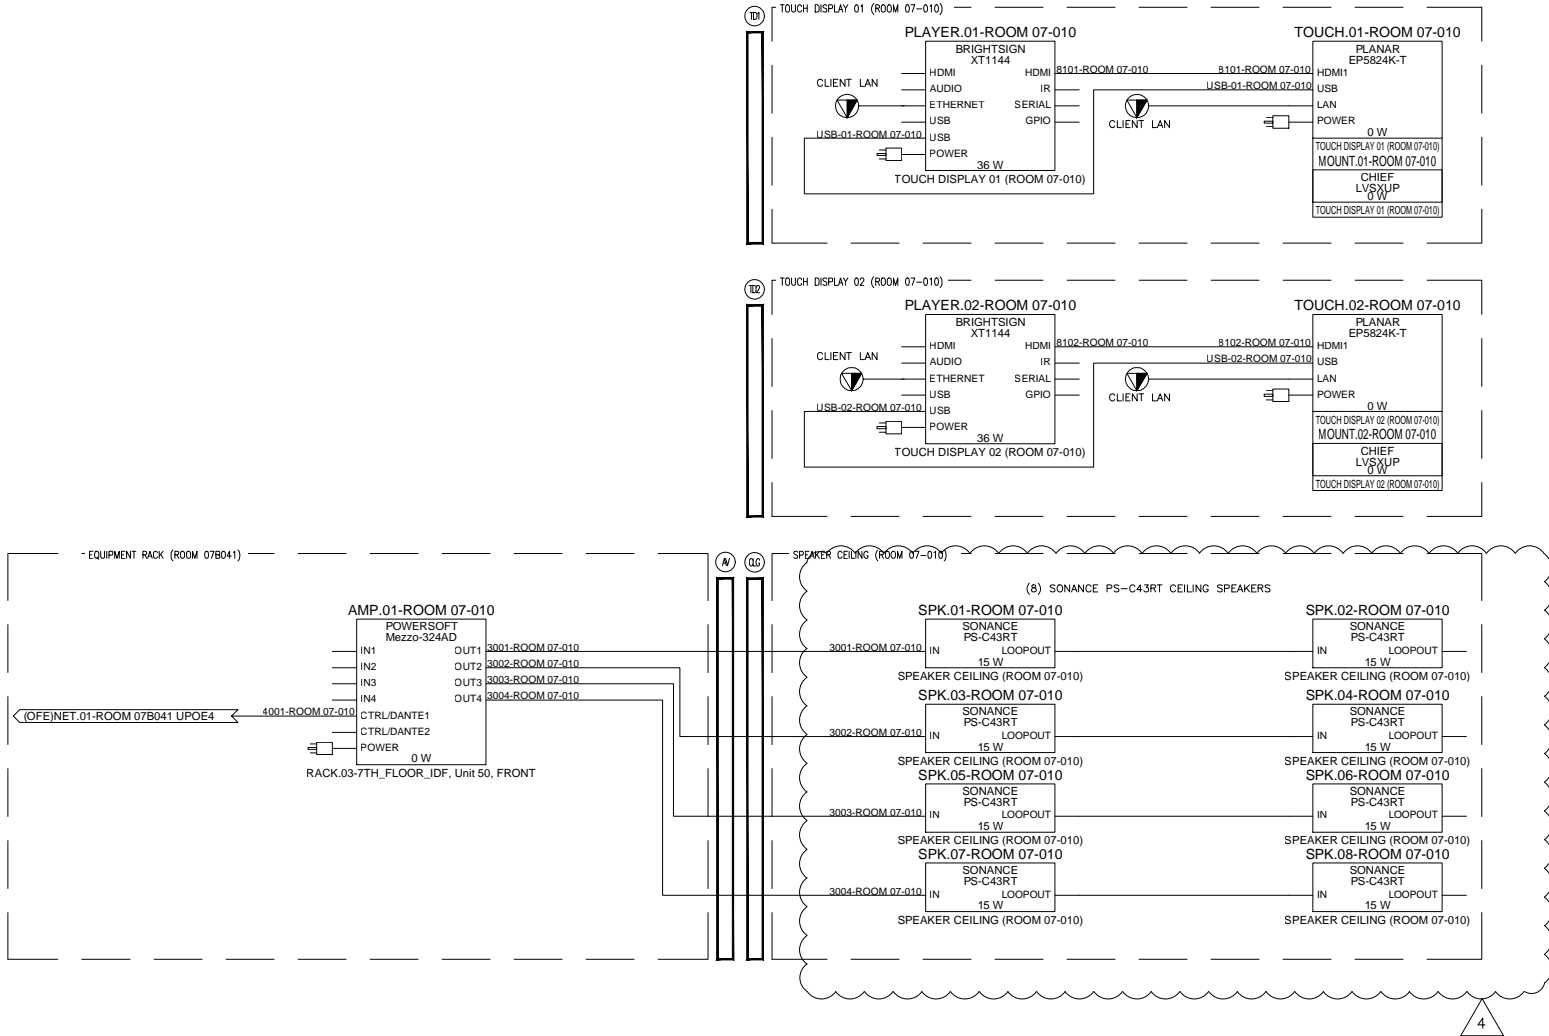

TYPE 48 AMENITIES ELEVATOR LOBBY B 07-010

SCALE: NTS

CableNumber	SysnameOut	ConnectorOut	PortOut	LocationOut	ModelOut	SysnameIn	ConnectorIn	PortIn	LocationIn	ModelIn	CableType
3001-ROOM 07-010	SPK.01-ROOM 07-010	3PIN	SPK	SPEAKER CEILING (ROOM 07-010)	QSC AD-C4T-LP	AMP.01-ROOM 07-010	PHX	OUT1	RACK.03-7TH_FLOOR_IDF, Unit 50, FRONT	POWERSOFT Mezzo-324AD	BELDEN 6100UE
3002-ROOM 07-010	SPK.03-ROOM 07-010	3PIN	SPK	SPEAKER CEILING (ROOM 07-010)	QSC AD-C4T-LP	AMP.01-ROOM 07-010	PHX	OUT2	RACK.03-7TH_FLOOR_IDF, Unit 50, FRONT	POWERSOFT Mezzo-324AD	BELDEN 6100UE
3003-ROOM 07-010	SPK.05-ROOM 07-010	3PIN	SPK	SPEAKER CEILING (ROOM 07-010)	QSC AD-C4T-LP	AMP.01-ROOM 07-010	PHX	OUT3	RACK.03-7TH_FLOOR_IDF, Unit 50, FRONT	POWERSOFT Mezzo-324AD	BELDEN 6100UE
3004-ROOM 07-010	SPK.07-ROOM 07-010	3PIN	SPK	SPEAKER CEILING (ROOM 07-010)	QSC AD-C4T-LP	AMP.01-ROOM 07-010	PHX	OUT4	RACK.03-7TH_FLOOR_IDF, Unit 50, FRONT	POWERSOFT Mezzo-324AD	BELDEN 6100UE