



Tad.



Corporate Headquarters:
625 Locust Street, Suite 300
Garden City, NY 11530
631 254 4500 - fax: 631 254 4499

PFIZER
66 HUDSON BOULEVARD
NEW YORK, NY 10001
7TH & 8TH FLOOR IDFS

ISSUE / REVISION LOG

No.	Description	Date
01	SUBMITTAL BULLETIN 4	01/14/22
02	SUBMITTAL UPDATES	05/06/22
03	CISCO CODEC SIGNAL FLOW	09/23/22
04	AS BUILTS	06/22/23
05	----	XX/XX/XX
06	----	XX/XX/XX
07	----	XX/XX/XX

[SUBMITTAL]

AUDIOVISUAL
RACK & POWER
DETAILS 03
(IDF 08D101)

SHEET TITLE:


AV.S02.103

DWG #:

PROJ #: ANY-21131

JC PROJ. MAN:	SK PROJ. ENG:	JL DRAWN BY:
------------------	------------------	-----------------

DATE: 10/29/21

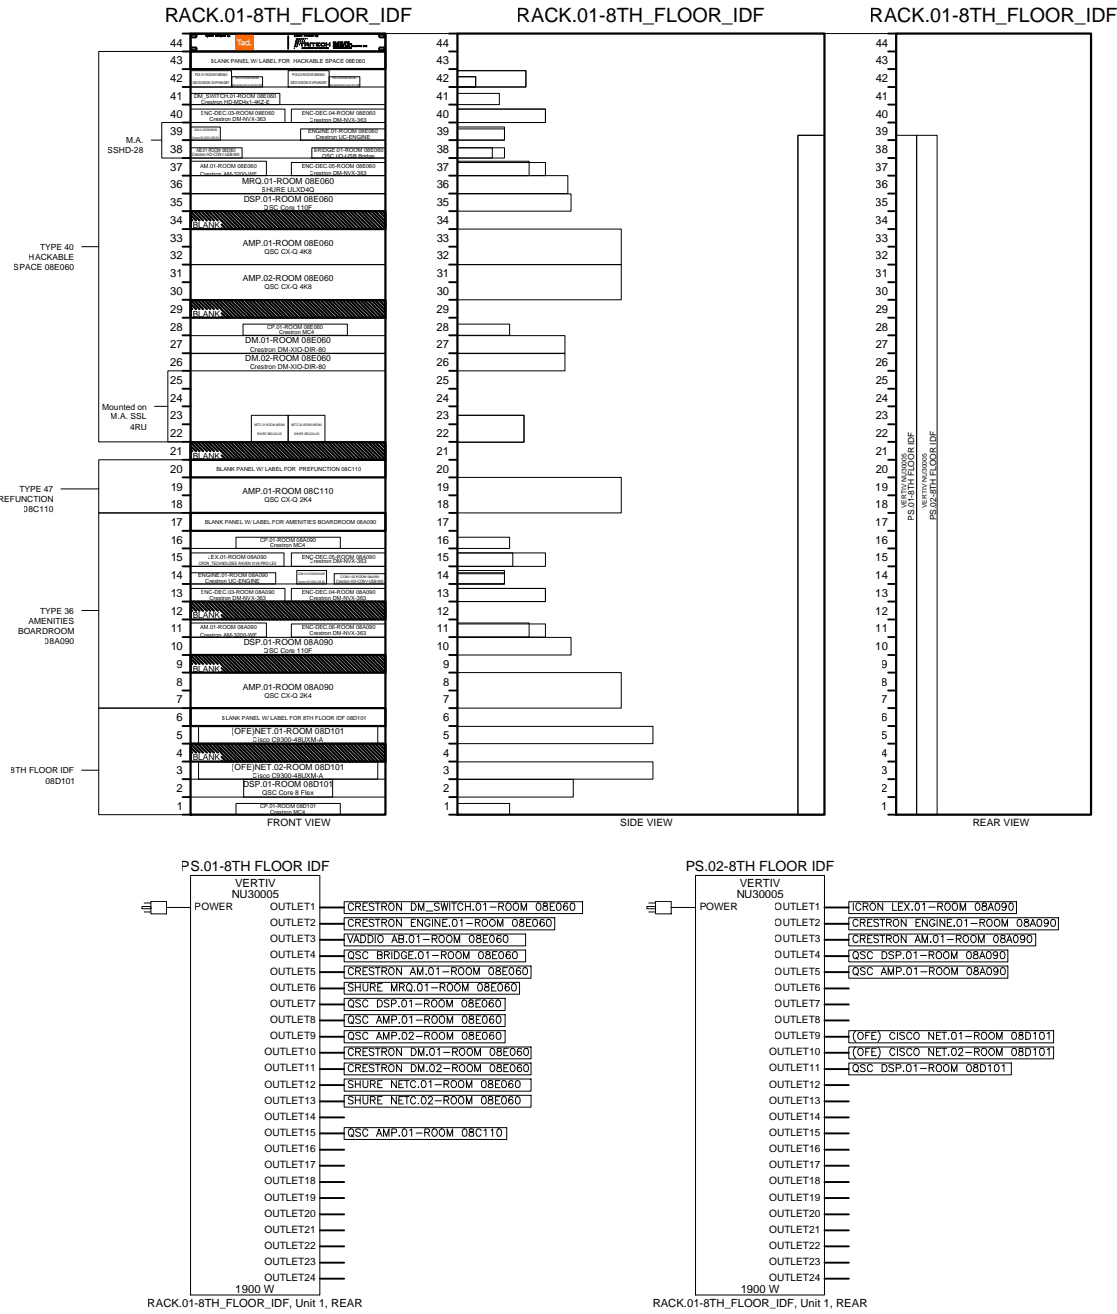

EQUIPMENT RACK-8TH FLOOR 08D101

1 - MIDDLE ATLANTIC MRK-4436LRD
1 - MIDDLE ATLANTIC SPN-44-36 (PAIR)
2 - VERTIV NU30005