



Tad.



Corporate Headquarters:
625 Locust Street, Suite 300
Garden City, NY 11530
631 254 4500 - fax: 631 254 4499

PFIZER

66 HUDSON BOULEVARD
NEW YORK, NY 10001
7TH & 8TH FLOOR IDFS

ISSUE / REVISION LOG

No.	Description	Date
01	SUBMITTAL BULLETIN 4	01/14/22
02	SUBMITTAL UPDATES	05/06/22
03	CISCO CODEC SIGNAL FLOW	09/23/22
04	AS BUILTS	06/22/23
05	----	XX/XX/XX
06	----	XX/XX/XX
07	----	XX/XX/XX

[SUBMITTAL]

AUDIOVISUAL
SYSTEM FLOWS &
PULL SCHEDULE
(ELEVATOR LOBBY
A 08C030)

SHEET TITLE:



AV.S02.227

DWG #:

PROJ #: ANY-21131

JC PROJ. MAN:	SK PROJ. ENG:	JL DRAWN BY:
------------------	------------------	-----------------

DATE: 10/29/21

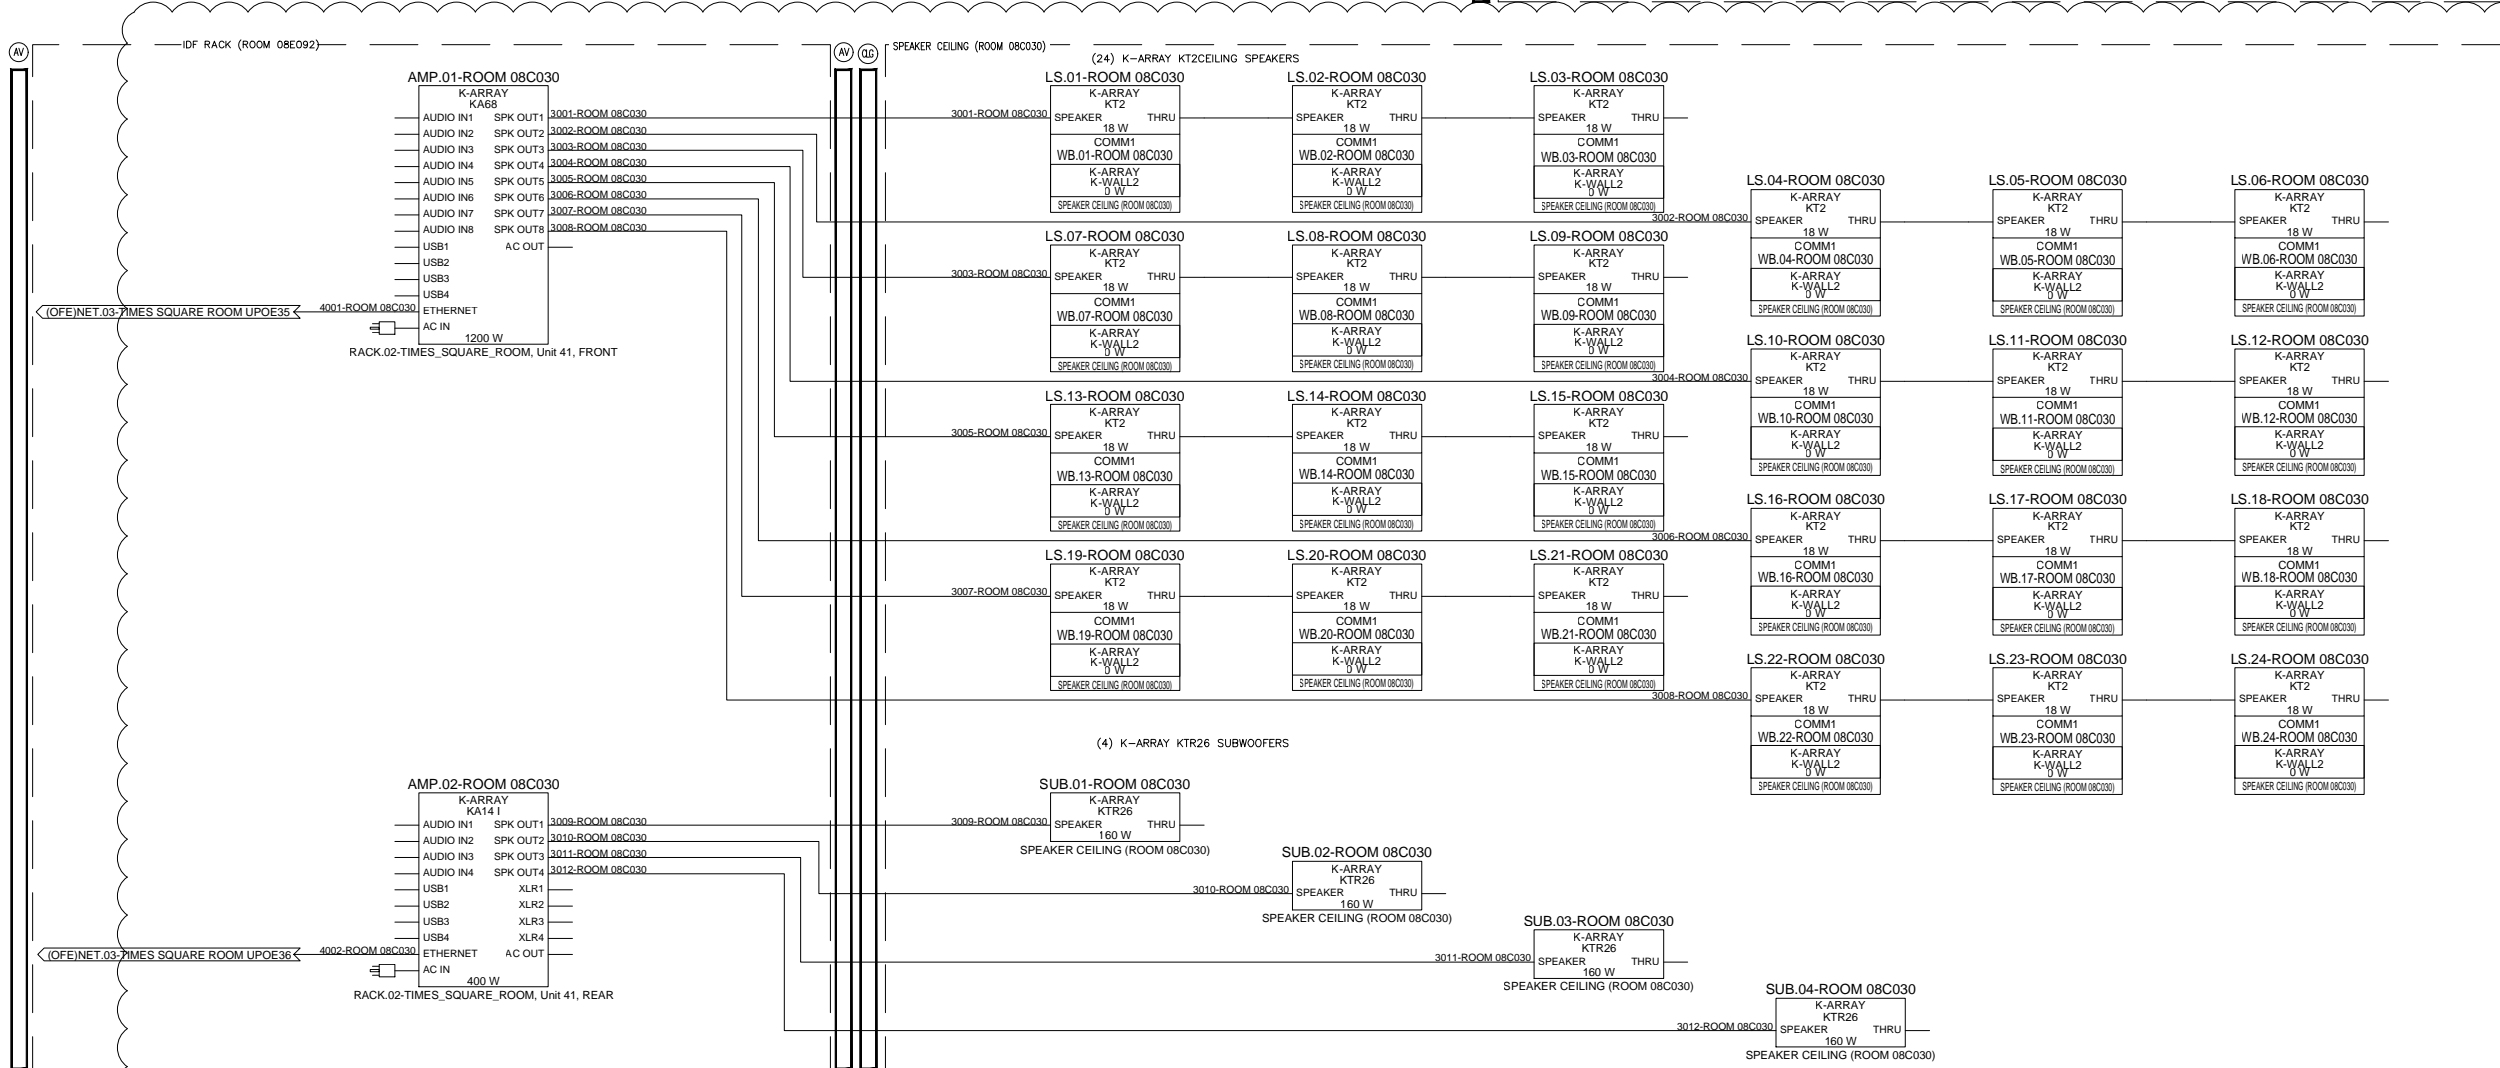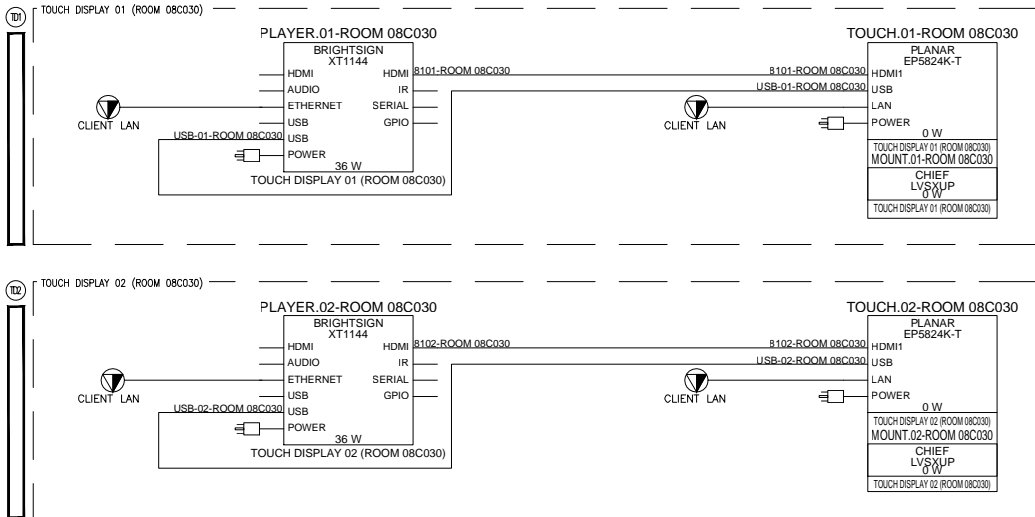

TYPE 23 ELEVATOR LOBBY A 08C030

SCALE: NTS

CableNumber	SysnameOut	ConnectorOut	PortOut	LocationOut	ModelOut	SysnameIn	ConnectorIn	PortIn	LocationIn	ModelIn	CableType
3001-ROOM 08C030	LS.01-ROOM 08C030	4PIN	SPEAKER	COMM1	K-ARRAY KT2	AMP.01-ROOM 08C030	PHX	SPK OUT1	RACK.02-TIMES_SQUARE_ROOM, Unit 41, FRONT	K-ARRAY KA68	BELDEN 6100UE
3002-ROOM 08C030	LS.04-ROOM 08C030	4PIN	SPEAKER	COMM1	K-ARRAY KT2	AMP.01-ROOM 08C030	PHX	SPK OUT2	RACK.02-TIMES_SQUARE_ROOM, Unit 41, FRONT	K-ARRAY KA68	BELDEN 6100UE
3003-ROOM 08C030	LS.07-ROOM 08C030	4PIN	SPEAKER	COMM1	K-ARRAY KT2	AMP.01-ROOM 08C030	PHX	SPK OUT3	RACK.02-TIMES_SQUARE_ROOM, Unit 41, FRONT	K-ARRAY KA68	BELDEN 6100UE
3004-ROOM 08C030	LS.10-ROOM 08C030	4PIN	SPEAKER	COMM1	K-ARRAY KT2	AMP.01-ROOM 08C030	PHX	SPK OUT4	RACK.02-TIMES_SQUARE_ROOM, Unit 41, FRONT	K-ARRAY KA68	BELDEN 6100UE
3005-ROOM 08C030	LS.13-ROOM 08C030	4PIN	SPEAKER	COMM1	K-ARRAY KT2	AMP.01-ROOM 08C030	PHX	SPK OUT5	RACK.02-TIMES_SQUARE_ROOM, Unit 41, FRONT	K-ARRAY KA68	BELDEN 6100UE
3006-ROOM 08C030	LS.16-ROOM 08C030	4PIN	SPEAKER	COMM1	K-ARRAY KT2	AMP.01-ROOM 08C030	PHX	SPK OUT6	RACK.02-TIMES_SQUARE_ROOM, Unit 41, FRONT	K-ARRAY KA68	BELDEN 6100UE
3007-ROOM 08C030	LS.19-ROOM 08C030	4PIN	SPEAKER	COMM1	K-ARRAY KT2	AMP.01-ROOM 08C030	PHX	SPK OUT7	RACK.02-TIMES_SQUARE_ROOM, Unit 41, FRONT	K-ARRAY KA68	BELDEN 6100UE
3008-ROOM 08C030	LS.22-ROOM 08C030	4PIN	SPEAKER	COMM1	K-ARRAY KT2	AMP.01-ROOM 08C030	PHX	SPK OUT8	RACK.02-TIMES_SQUARE_ROOM, Unit 41, FRONT	K-ARRAY KA68	BELDEN 6100UE
3009-ROOM 08C030	SUB.01-ROOM 08C030	4PIN	SPEAKER	SPEAKER CEILING (ROOM 08C030)	K-ARRAY KTR26	AMP.02-ROOM 08C030	PHX	SPK OUT1	RACK.02-TIMES_SQUARE_ROOM, Unit 41, REAR	K-ARRAY KA14 I	BELDEN 6100UE
3010-ROOM 08C030	SUB.02-ROOM 08C030	4PIN	SPEAKER	SPEAKER CEILING (ROOM 08C030)	K-ARRAY KTR26	AMP.02-ROOM 08C030	PHX	SPK OUT2	RACK.02-TIMES_SQUARE_ROOM, Unit 41, REAR	K-ARRAY KA14 I	BELDEN 6100UE
3011-ROOM 08C030	SUB.03-ROOM 08C030	4PIN	SPEAKER	SPEAKER CEILING (ROOM 08C030)	K-ARRAY KTR26	AMP.02-ROOM 08C030	PHX	SPK OUT3	RACK.02-TIMES_SQUARE_ROOM, Unit 41, REAR	K-ARRAY KA14 I	BELDEN 6100UE
3012-ROOM 08C030	SUB.04-ROOM 08C030	4PIN	SPEAKER	SPEAKER CEILING (ROOM 08C030)	K-ARRAY KTR26	AMP.02-ROOM 08C030	PHX	SPK OUT4	RACK.02-TIMES_SQUARE_ROOM, Unit 41, REAR	K-ARRAY KA14 I	BELDEN 6100UE