

30" x 42" - Arch D Size

2.0 2.3 3.0 4.0 5.0 6.0 7.0 8.0 9.0 10.0 11.0

SHEET NOTES:  
1. ROUTE ALL DEVICES, UNLESS OTHERWISE NOTED, TO IDF/AV/POE ROOM 07B041.



JOHNSON  
CONTROLS

888.442.4627  
PHONE  
800.442.4627  
FAX  
145  
NEW YORK, NY  
SECAUCUS, NJ 07094



tmt  
technology  
partners, llc

CONSULTING DESIGN PROJECT MANAGEMENT

- NO EXCEPTIONS TAKEN
- CORRECT AS NOTED
- REVISE & RESUBMIT
- REJECTED
- NOT REVIEWED

PFIZER NYHQ  
66 HUDSON BOULEVARD, NEW YORK, NY 10001

ISSUE NO.	DATE	CHK	DESCRIPTION
1	08/27/2021	JN	ISSUE NO. 1 - 08/27/2021 - 01
2	08/27/2021	JN	ISSUE NO. 2 - 08/27/2021 - 02
3	08/27/2021	JN	ISSUE NO. 3 - 08/27/2021 - 03
4	08/27/2021	JN	ISSUE NO. 4 - 08/27/2021 - 04
5	08/27/2021	JN	ISSUE NO. 5 - 08/27/2021 - 05
6	08/27/2021	JN	ISSUE NO. 6 - 08/27/2021 - 06
7	08/27/2021	JN	ISSUE NO. 7 - 08/27/2021 - 07
8	08/27/2021	JN	ISSUE NO. 8 - 08/27/2021 - 08
9	08/27/2021	JN	ISSUE NO. 9 - 08/27/2021 - 09
10	08/27/2021	JN	ISSUE NO. 10 - 08/27/2021 - 10
11	08/27/2021	JN	ISSUE NO. 11 - 08/27/2021 - 11
12	08/27/2021	JN	ISSUE NO. 12 - 08/27/2021 - 12
13	08/27/2021	JN	ISSUE NO. 13 - 08/27/2021 - 13
14	08/27/2021	JN	ISSUE NO. 14 - 08/27/2021 - 14
15	08/27/2021	JN	ISSUE NO. 15 - 08/27/2021 - 15
16	08/27/2021	JN	ISSUE NO. 16 - 08/27/2021 - 16
17	08/27/2021	JN	ISSUE NO. 17 - 08/27/2021 - 17
18	08/27/2021	JN	ISSUE NO. 18 - 08/27/2021 - 18
19	08/27/2021	JN	ISSUE NO. 19 - 08/27/2021 - 19
20	08/27/2021	JN	ISSUE NO. 20 - 08/27/2021 - 20

DRAWN BY: J. Hauser

CHECKED BY: J. Newby

ISSUE DATE: 08/27/2021


JOB NUMBER: 1N720235


PROJECT #: 2021

SYSTEM: ACS, VSS, & ECS

SHEET: 7TH FLOOR DEVICE PLACEMENT PLAN

SE-105

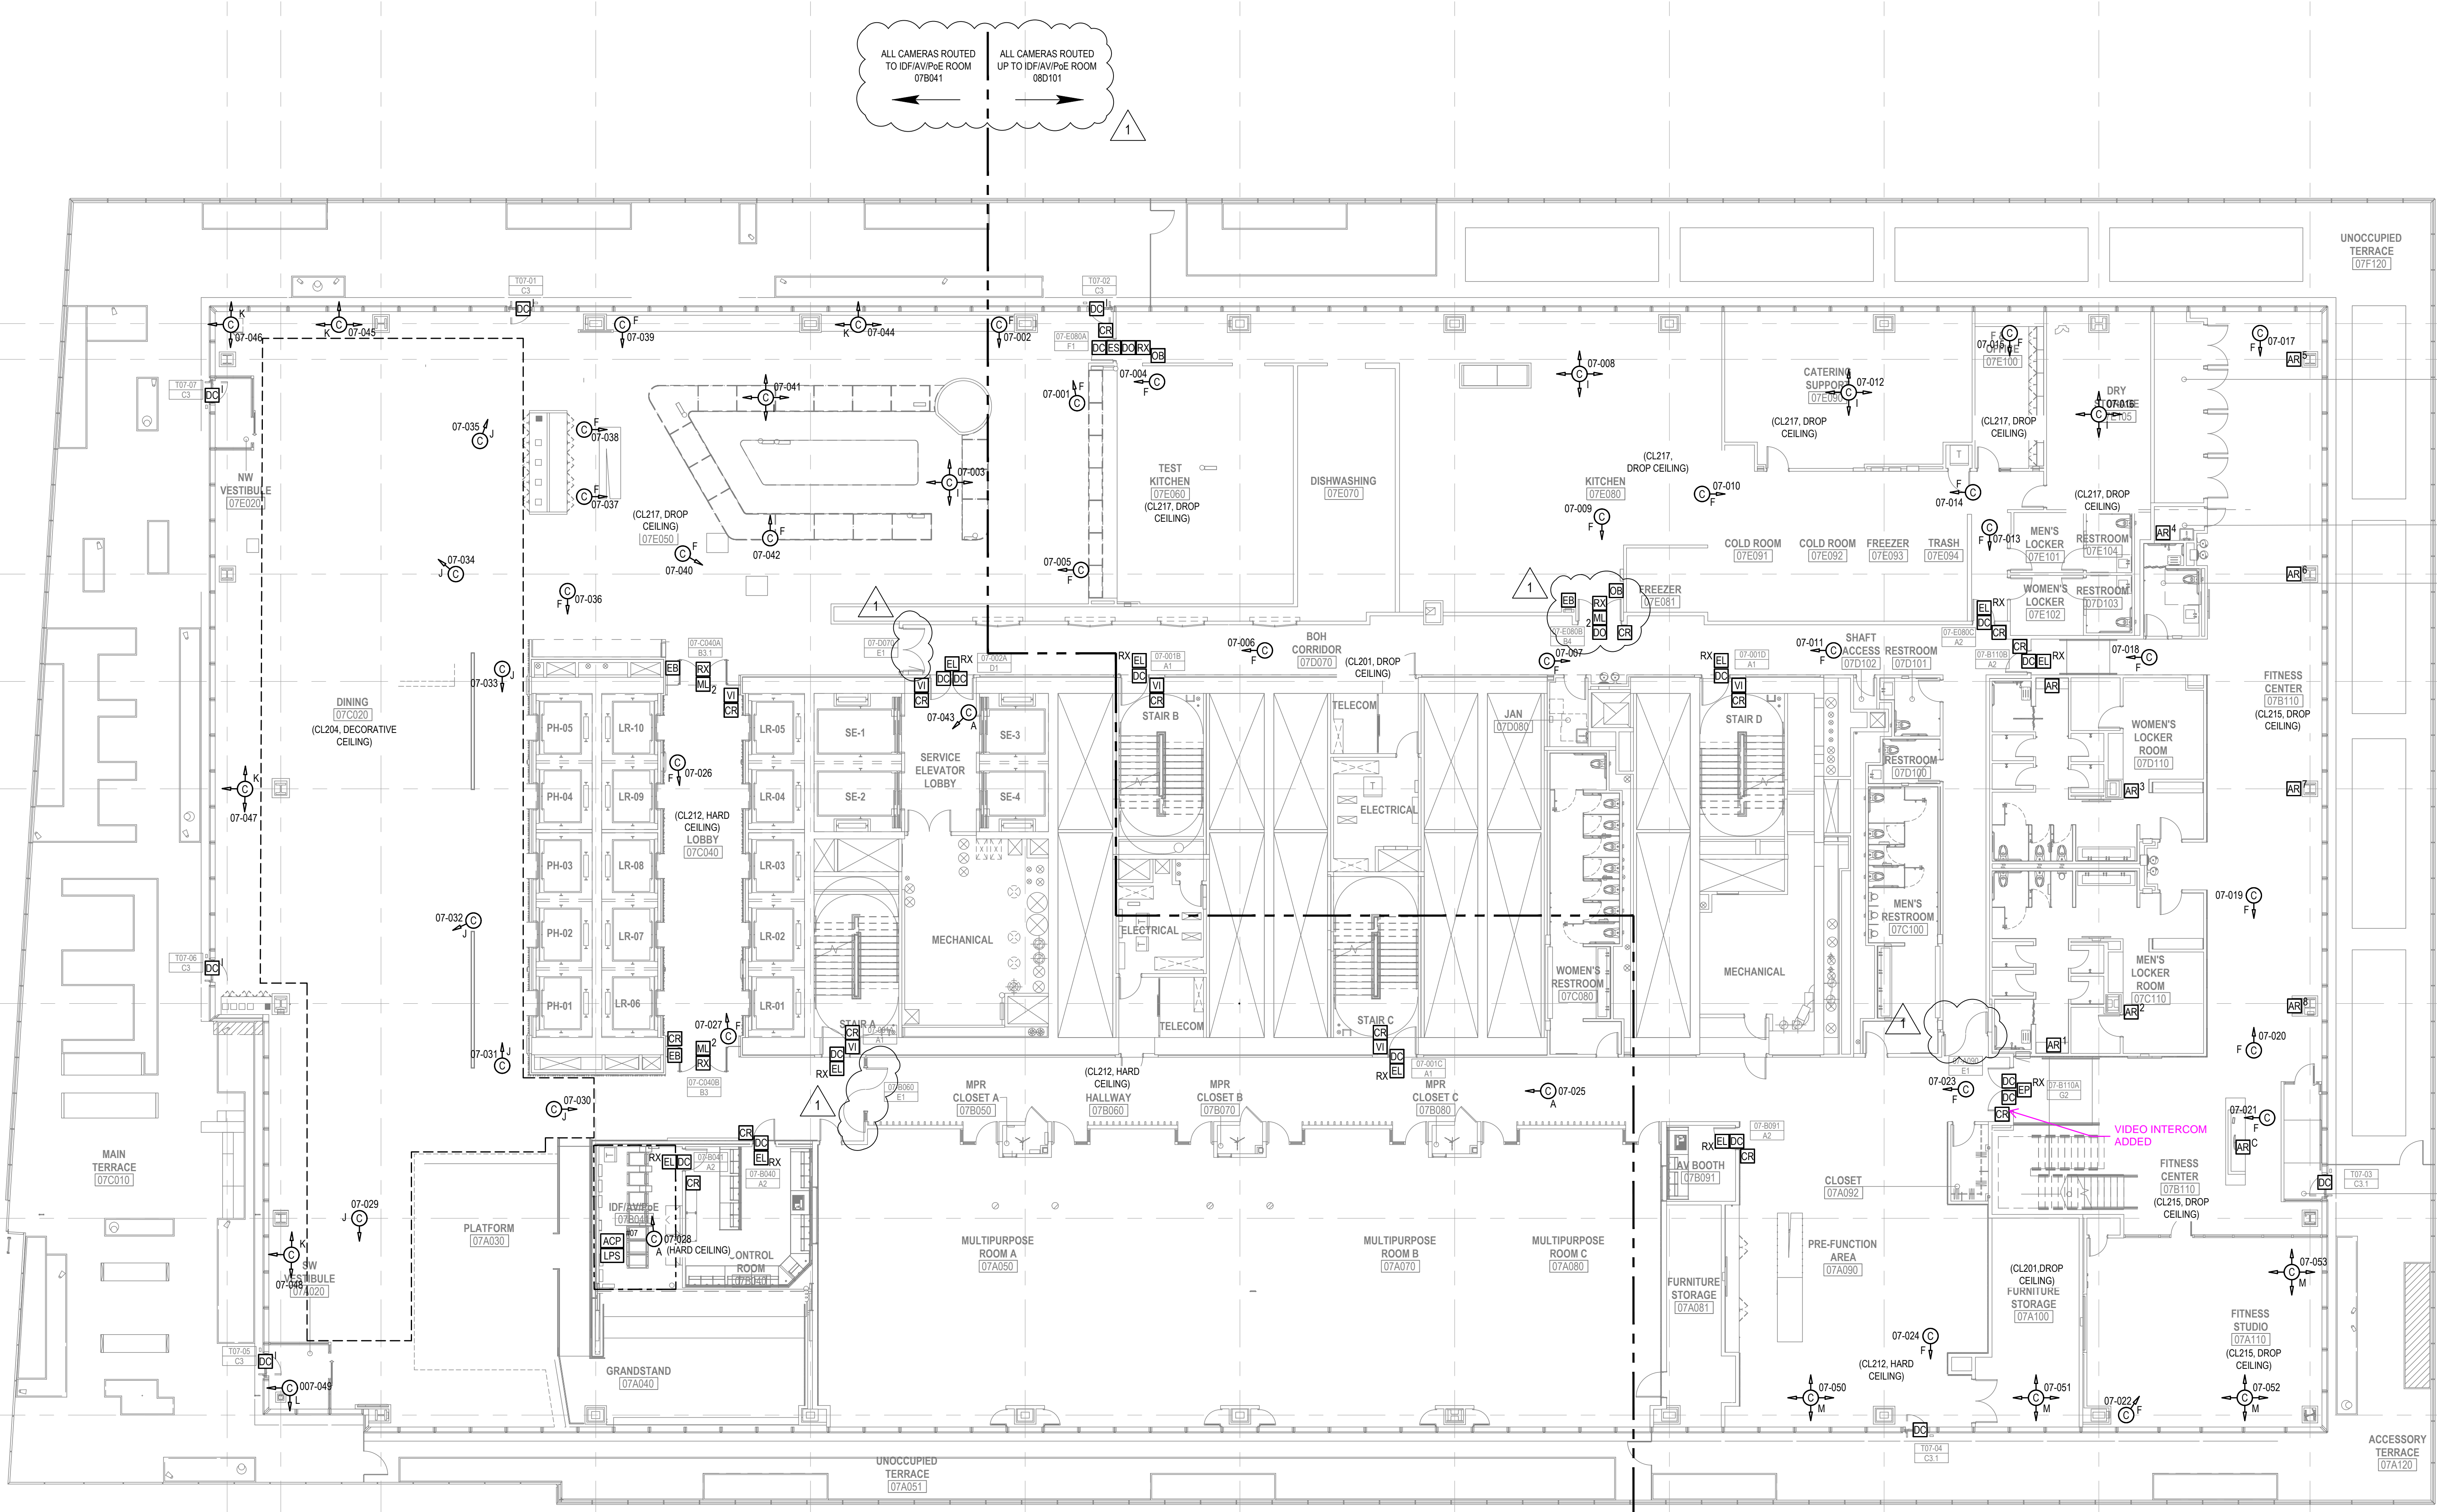

 **DEVICE PLACEMENT PLAN - 7th FLOOR PLAN**  
SCALE: 3/32" = 1'-0"  
SCALE: 3/32" = 1'-0" IN FEET  
0 6 12 18 24