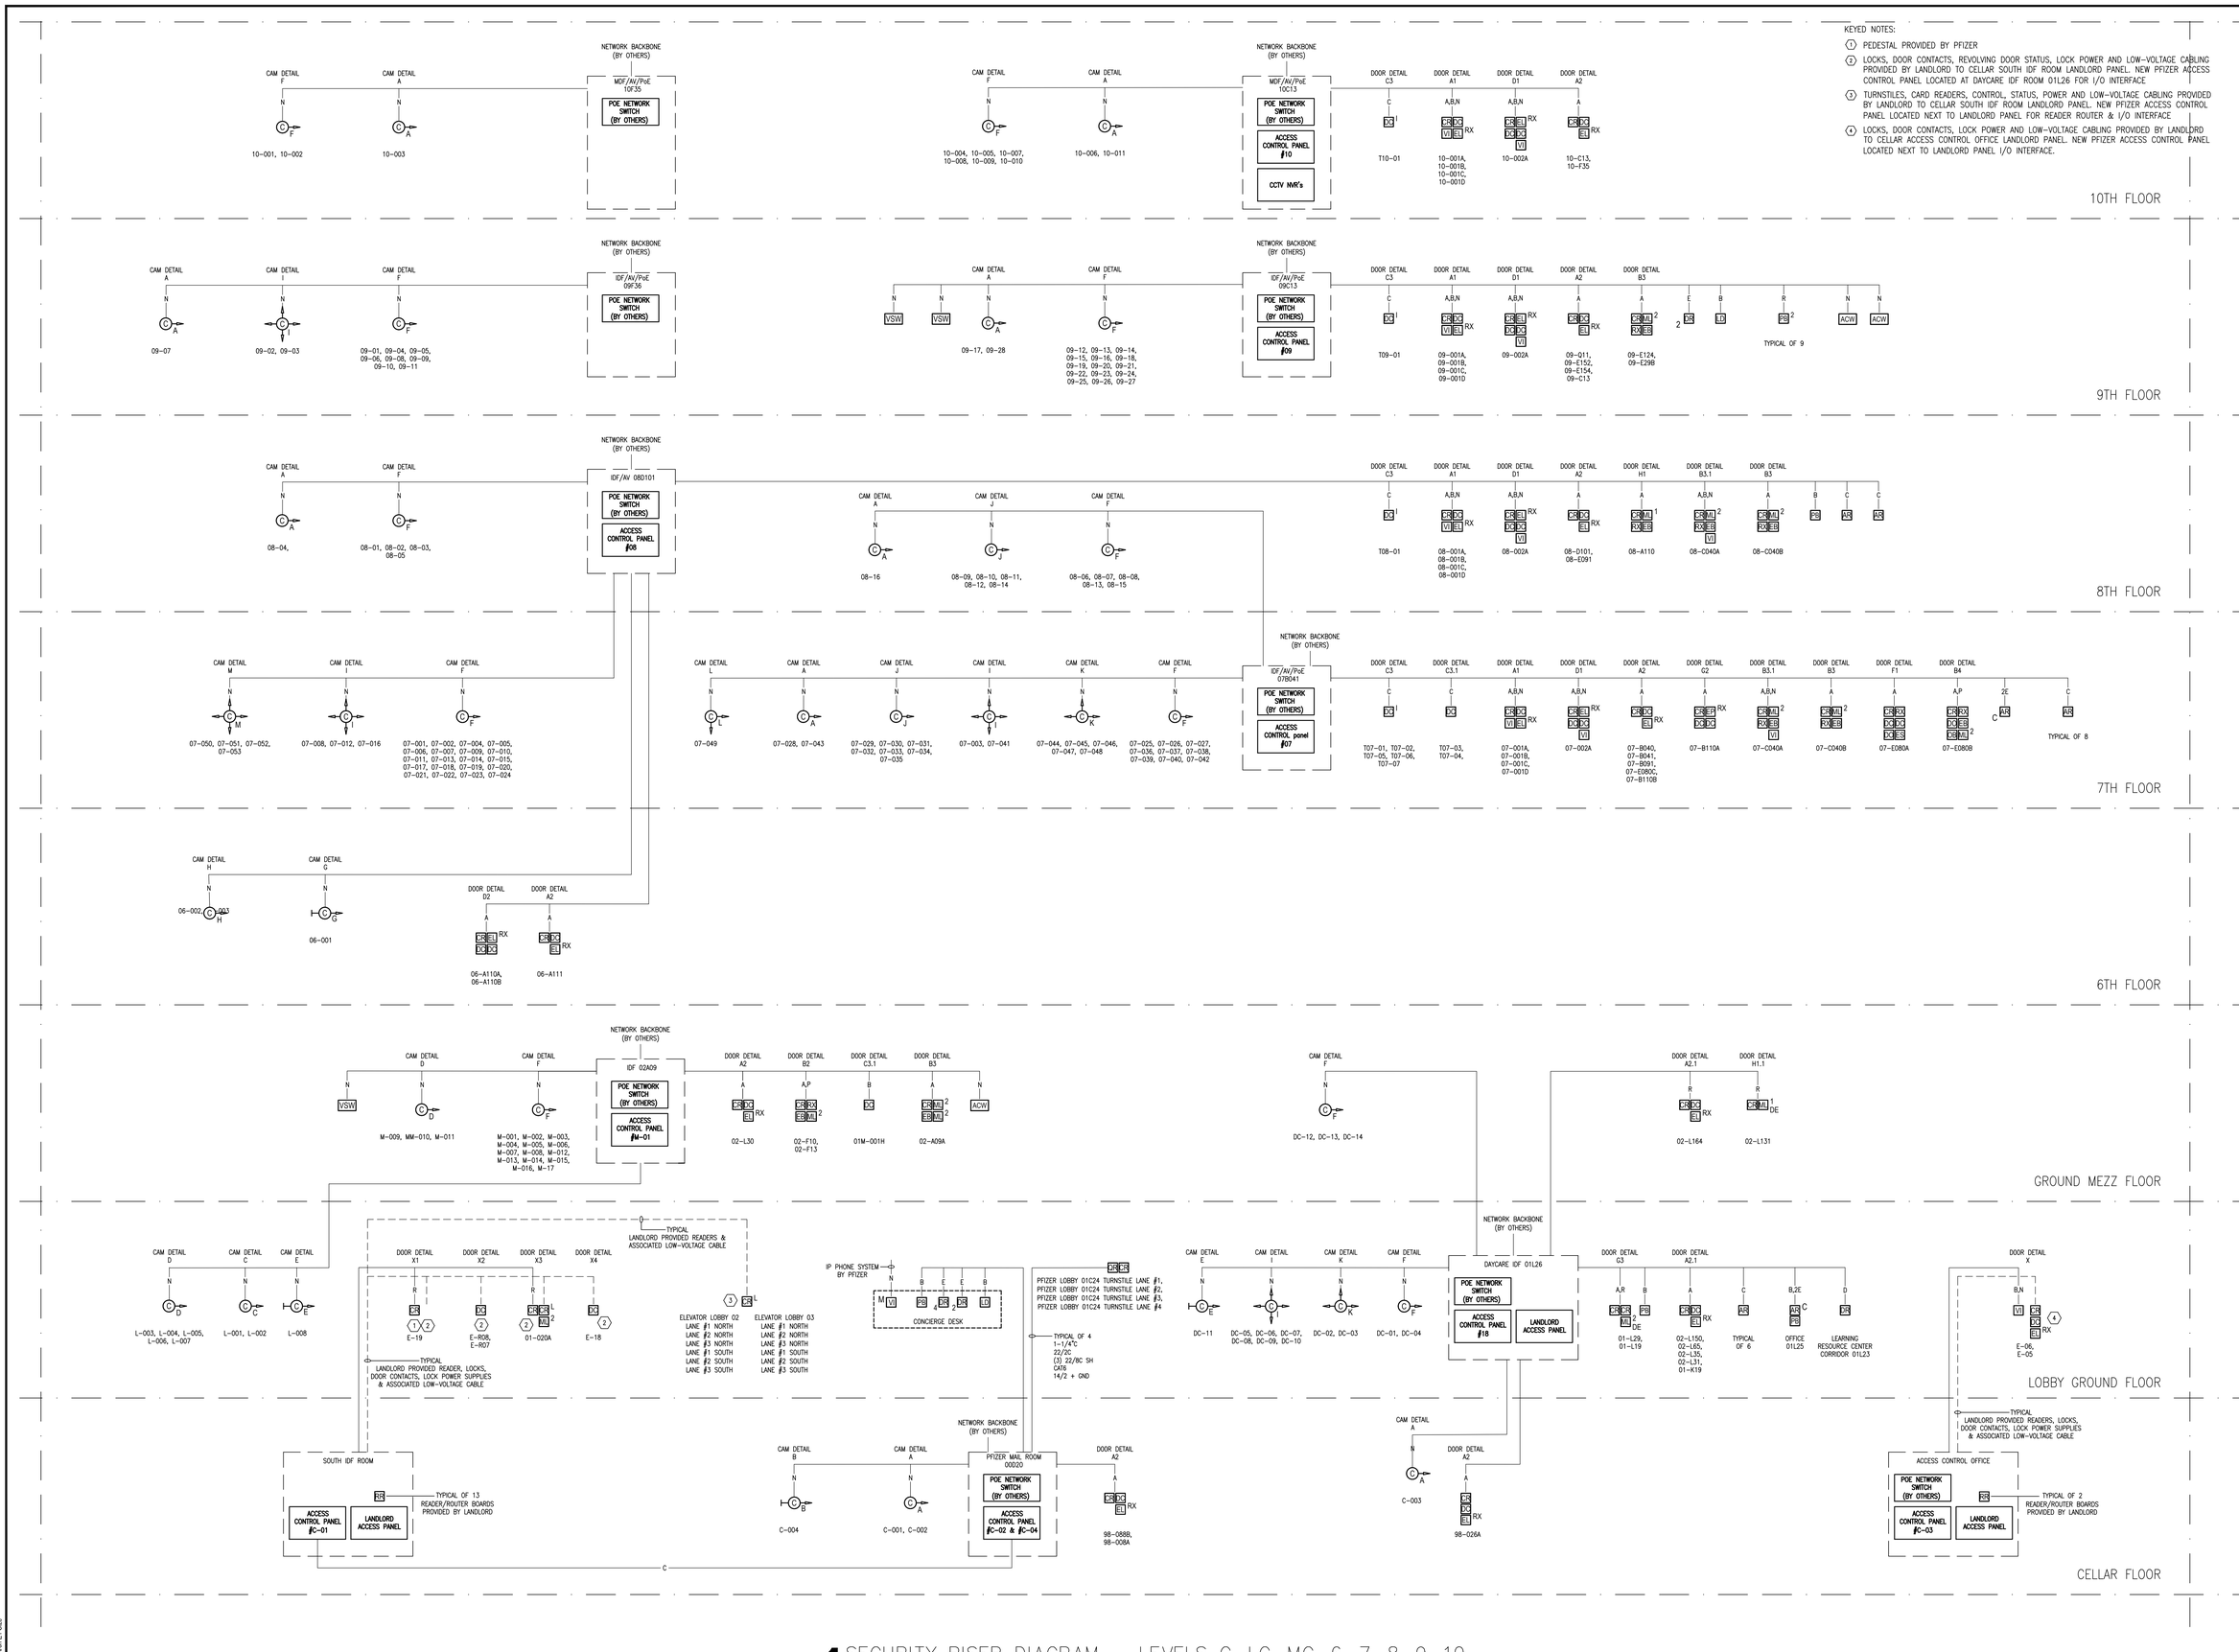

KEYED NOTES:

1. PEDESTAL PROVIDED BY PFIZER
2. LOCKS, DOOR CONTACTS, REVOLVING DOOR STATUS, LOCK POWER AND LOW-VOLTAGE CABLING PROVIDED BY LANDLORD TO CELLAR SOUTH IDF ROOM LANDLORD PANEL. NEW PFIZER ACCESS CONTROL PANEL LOCATED AT DAYCARE IDF ROOM 01L26 FOR I/O INTERFACE
3. TURNSTILES, CARD READERS, CONTROL, STATUS, POWER AND LOW-VOLTAGE CABLING PROVIDED BY LANDLORD TO CELLAR SOUTH IDF ROOM LANDLORD PANEL. NEW PFIZER ACCESS CONTROL PANEL LOCATED NEXT TO LANDLORD PANEL FOR READER ROUTER & I/O INTERFACE
4. LOCKS, DOOR CONTACTS, LOCK POWER AND LOW-VOLTAGE CABLING PROVIDED BY LANDLORD TO CELLAR ACCESS CONTROL OFFICE LANDLORD PANEL. NEW PFIZER ACCESS CONTROL PANEL LOCATED NEXT TO LANDLORD PANEL I/O INTERFACE.

1 SECURITY RISER DIAGRAM – LEVELS C–LG–MG–6–7–8–9–10

Johnson Controls
DISTRICT : 143
1000 CHESTNUT RIDGE RD.
SECAUCUS, NJ 07094
PHONE: (888) 447-4027
SERVICE: (800) 829-6964
FAX: (212) 482-4504

tmttechnology partners, llc
CONSULTING · DESIGN · PROJECT MANAGEMENT

- ☒ NO EXCEPTIONS TAKEN
- ☐ CORRECT AS NOTED
- ☐ REVISE & RESUBMIT
- ☐ REJECTED
- ☐ NOT REVIEWED

PFIZER NYHQ

66 HUDSON BOULEVARD, NEW YORK, NY 10001

Revisions shown as: 3D/D3

ISSUE LOG				
MARK	DATE	CAD	CHK	DESCRIPTION
0	8/27/21	JH	JH	NOT CONSTRUCTION
1	6/16/22	JH	JH	ISSUED PER SHOP DRAWING REVIEW INF-281003-D06-01

DRAWN BY:	J. Hauser
CHECKED BY:	J. Newby
ISSUE DATE:	08/27/2021
JOB NUMBER:	
PROJECT #:	1N720235
	2021

SYSTEM: ACS, VSS, & ECS

SHEET: SYSTEMS RISER DIAGRAM

1 SE-201

IMPORTANT NOTICE TO USERS: By accepting or using this drawing and/or the information contained herein, the user agrees to the following terms and conditions. The electronic information in the drawing may be subject to translation or unintentional alteration. Any use, reuse, copying, modification or distribution of the information contained herein shall be at the sole risk of the user. This information may not be sold or transferred to any third party without prior written consent of Johnson Controls. Any copy of this drawing or any portion thereof, in any medium, must include this notice in its entirety. Any copy of this drawing or any portion thereof, in any medium, may be subject to alteration or deletion by Johnson Controls. Johnson Controls shall not be responsible for any modifications to this drawing made after the original issue date.

30" x 42" - Arch E1 Size